
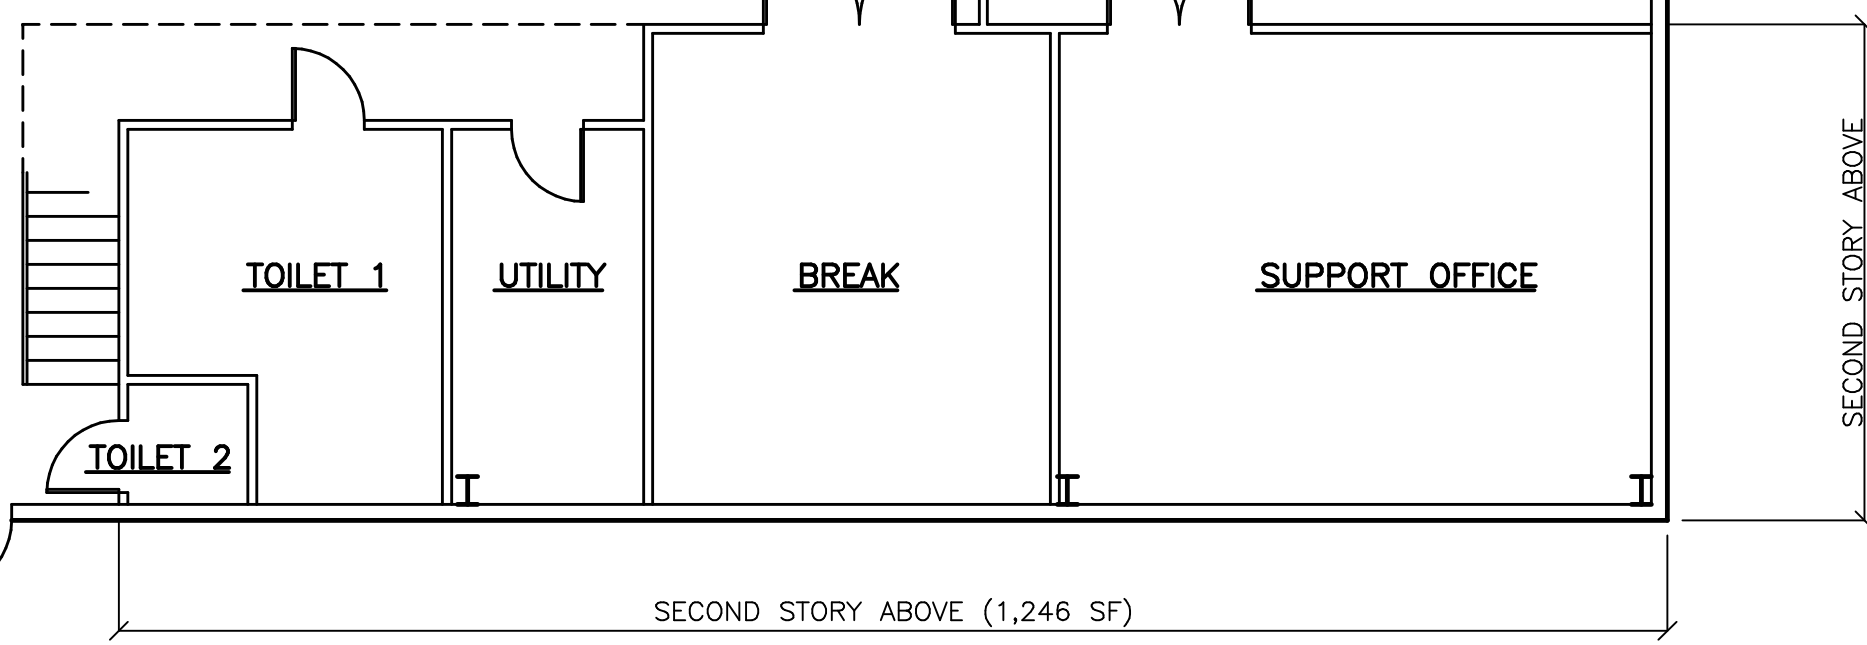



DIAGRAMMATIC AS BUILT FLOOR PLAN 1/8"=1'-0"

SQUARE FOOTAGE TABULATION

FIRST FLOOR INDUSTRIAL BUSINESS	1,246 SF
FIRST FLOOR INDUSTRIAL SHOP	18,204 SF
INDUSTRIAL BUILDING FIRST FLOOR TOTAL	19,450 SF
SECOND FLOOR INDUSTRIAL BUSINESS	1,246 SF
INDUSTRIAL BUILDING TOTAL	20,696 SF
BUSINESS BUILDING TOTAL	1,320 SF
TOTAL USABLE SPACE	22,016 SF
OUTSIDE COVERED STORAGE	1,535 SF

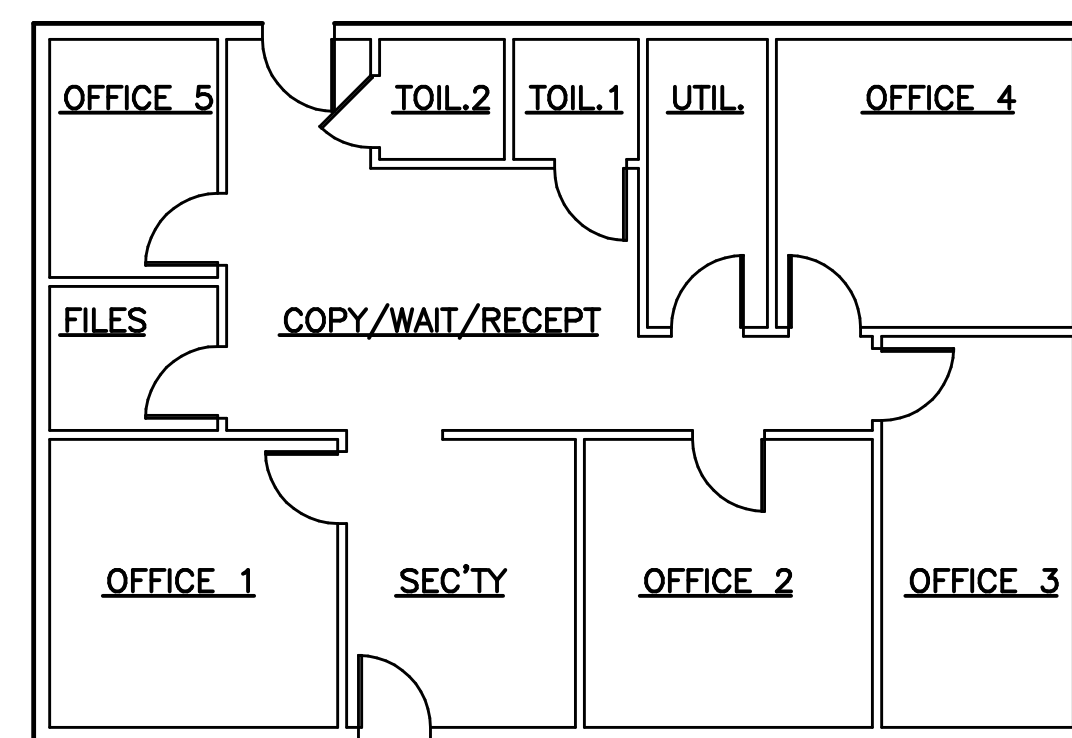

CLEAR FOR REVIEW ONLY
NOT FOR CONSTRUCTION
02-13-13

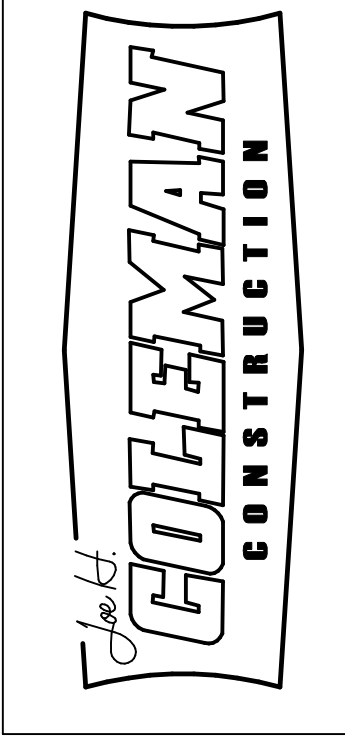

© 2013 CHRISTOPHER N. TANNER, ASSOC. AIA
THESE DOCUMENTS HAVE BEEN PREPARED FOR
THIS SPECIFIC PROJECT AND NO ALTERATIONS
MAY BE MADE TO THEM NOR MAY THEY BE
USED FOR OTHER PROJECTS IN OTHER
LOCATIONS WITHOUT THE PRIOR APPROVAL
AND PARTICIPATION OF CLEAR DESIGNING
UNAUTHORIZED REPRODUCTION IS PROHIBITED

project number:	13014
designed:	CNT
drawn:	CNT
approved:	?
date:	?
revisions:	?

clear DESIGNING
CHRISTOPHER N. TANNER, ASSOC. AIA
P.O. BOX 1116
FUSTBURG, VIRGINIA 24588
PH: (634) 299-3344
www.cleardesigning.com
chris@cleardesigning.com

PROPOSED BUILDING LOCATION
1400 COMMONWEALTH BLVD
MADISON HEIGHTS, VA 24572

CAKEBOXX TECHNOLOGIES
STRONG, SECURE, AND EFFICIENT SOLUTIONS.

drawing title: DIAGRAMMATIC AS BUILT BUILDING PLAN

reference: ARCHITECTURAL

FOR REVIEW ONLY
NOT FOR CONSTRUCTION
02-13-13

drawing number	AB-1
of	1
sheet	1 of 1

0 2 4 6 8 16' 32'